

Design Review Board Meeting Agenda Date: August 23, 2023 Time: 11:00 am

CVC DRB Members: Michael Current Steve McKeever Jeff Townsend Bobby Ladd

Location: Via Zoom

Project Reviews (11:00 am)

 Johnson Residence - Fenced-in Dog Run 100 Legends Drive Unit A / Filing 10 Lot 7 Owner: Bruce Johnson Applicant: Jeff Townsend, Resort Concepts

Cordillera Valley Club Design Review Board Staff Memorandum

Owner:	Bruce Johnson
Address:	100 Legends Drive Unit A
Legal Address:	Lot 7
Representative:	Jeff Townsend, Resorts Concepts
Architect:	Don Eggers, Eggers Architecture
Staff Contact:	Allison Kent, AICP
DRB Hearing #1:	August 23, 2023

Project Description

• The applicant is requesting a fenced in dog run







970.390.8530 Allison@mpgvail.com

CHANGES TO APPROVED PLANS - August 23, 2023

Project Review

A. Site Plan and Landscape Plan Comments

- 1. The applicant is requesting a fenced in dog-run. The fence is split-rail with wire mesh, and is approximately 3.5 ft. tall.
- 2. The applicant is proposing landscaping to screen the fence from the adjacent roadways. However, staff is concerned that it will be visible from Beard Creek Trail and/or Legends Drive.
- 3. Due to its location, this lot is challenging to provide a fenced in dog-run that will not be visible. However, staff believes there may be alternatives, including using the existing patio and extending stone walls to create a similar enclosure.
- 4. There are two areas in which the Design Guidelines regulate fencing. The Design Guidelines state:

3.13 ACCESSORY STRUCTURES AND USES

In order to ensure cohesive unified development in the Cordillera Valley Club, all accessory structures such as spas, trampolines, swing sets, jungle gyms, water features, fire pits, gazebos, kennels, dog runs and other similar features shall be physically and architecturally integrated with the main residence, and must be located within the building envelope. Please refer to Section 2.7 - Exterior Equipment and Recreational Equipment for additional information.

Design Considerations

- Accessory structures should be physically and visually connected with the main residence thru the use of structural elements, site walls, covered walkways or landscaping.
- All accessory structures shall use building materials, colors, architectural styles and forms consistent with the main residence.
- Enclosed areas shall be provided for Spring C containers, maintenance and recreational equipment, and the storage of firewood and seasonal equipment such as patio furniture.
- Pursuant to Article XVIII of the Covenants, no owner shall construct any fencing on the property except for small dog runs, children's play areas and/or to enclose a maximum of one thousand (1,000) square feet of property immediately adjacent to a residential dwelling. Dog runs may be approved by the DRB, however, they must be located within the building envelope contiguous to the main residence and be fully screened from the Cordillera Valley Golf Course and Clubhouse, adjacent properties, and roadways. At the discretion of the DRB, certain homesites may not be permitted to have a dog run due to the potential visibility from surrounding areas. Dog runs shall be constructed of materials consistent with the main residence.

4.7 RETAINING WALLS, LANDSCAPE WALLS AND FENCES

Design Considerations for Fences:

- Fencing of any kind is discouraged within CVC and will only be approved when compliance with provisions herein can be accomplished.
- Fencing is limited to enclosing a maximum of one thousand (1,000) square feet of lot immediately adjacent to a residential dwelling (i.e., within approximately twenty (20) feet of the foundation of the home) to allow for dog runs, play areas for children, and similar purposes (per Declaration of Covenants, Conditions, Restrictions and Easements for Cordillera Valley Club).
- No perimeter lot fencing or the arbitrary fencing of building envelope areas is permitted. Fencing must compliment the design, the materials and the color of the residence. Applicant must submit fencing details to the DRB for approval and a sample of the proposed material (with the proposed color and finish).
- Fencing must be placed so that it is inconspicuous when viewed from surrounding properties, the golf course, the street, or other public areas. Fencing should be limited in height to a maximum of four (4) feet and shall appear open with a character of an open rail fence or similar design that tends to disappear from view at a distance. Solid or largely opaque fences are not permitted. Whenever possible, retaining walls and landscape materials should be used in-lieu of fencing to create enclosure and restrict access.
- Landscape materials should be used to further mitigate the visibility of any approved fence but should not be considered as a full remedy from the visibility provisions contained herein.
- The DRB may approve minor deviations from the fencing requirements when it can be demonstrated that: 1. The proposal complies with the overall intent of the design considerations; 2. The proposal complies with the Declaration of Covenants, Conditions, Restrictions and Easement for Cordillera Valley Club; and 3. The proposal does not adversely affect views from surrounding properties, the golf course, the street, or other public areas.

B. Staff Recommendation

Staff recommends the DRB provide input on the proposed fenced in dog run. Should the DRB choose to approve the dog-run at Lot 7 of the Club Residences, staff recommends the following conditions:

- 1. General Condition: Compliance with the CVC Design Guidelines and process is not a substitute for compliance with Eagle County regulations, State regulations, or Federal regulations. Additional permits and approvals may be required by these agencies prior to commencing any work on the property. The property owner and its agents are responsible for ensuring compliance with all local, state, and federal regulations.
- 2. The fence shall be screened with landscaping to ensure that it is not visible from the golf course or public roadway.
- 3. A compliance deposit in the amount of \$10,000 shall be required to ensure that the fence is adequately landscaped. The deposit shall not be refunded until staff verifies the fencing is not visible.














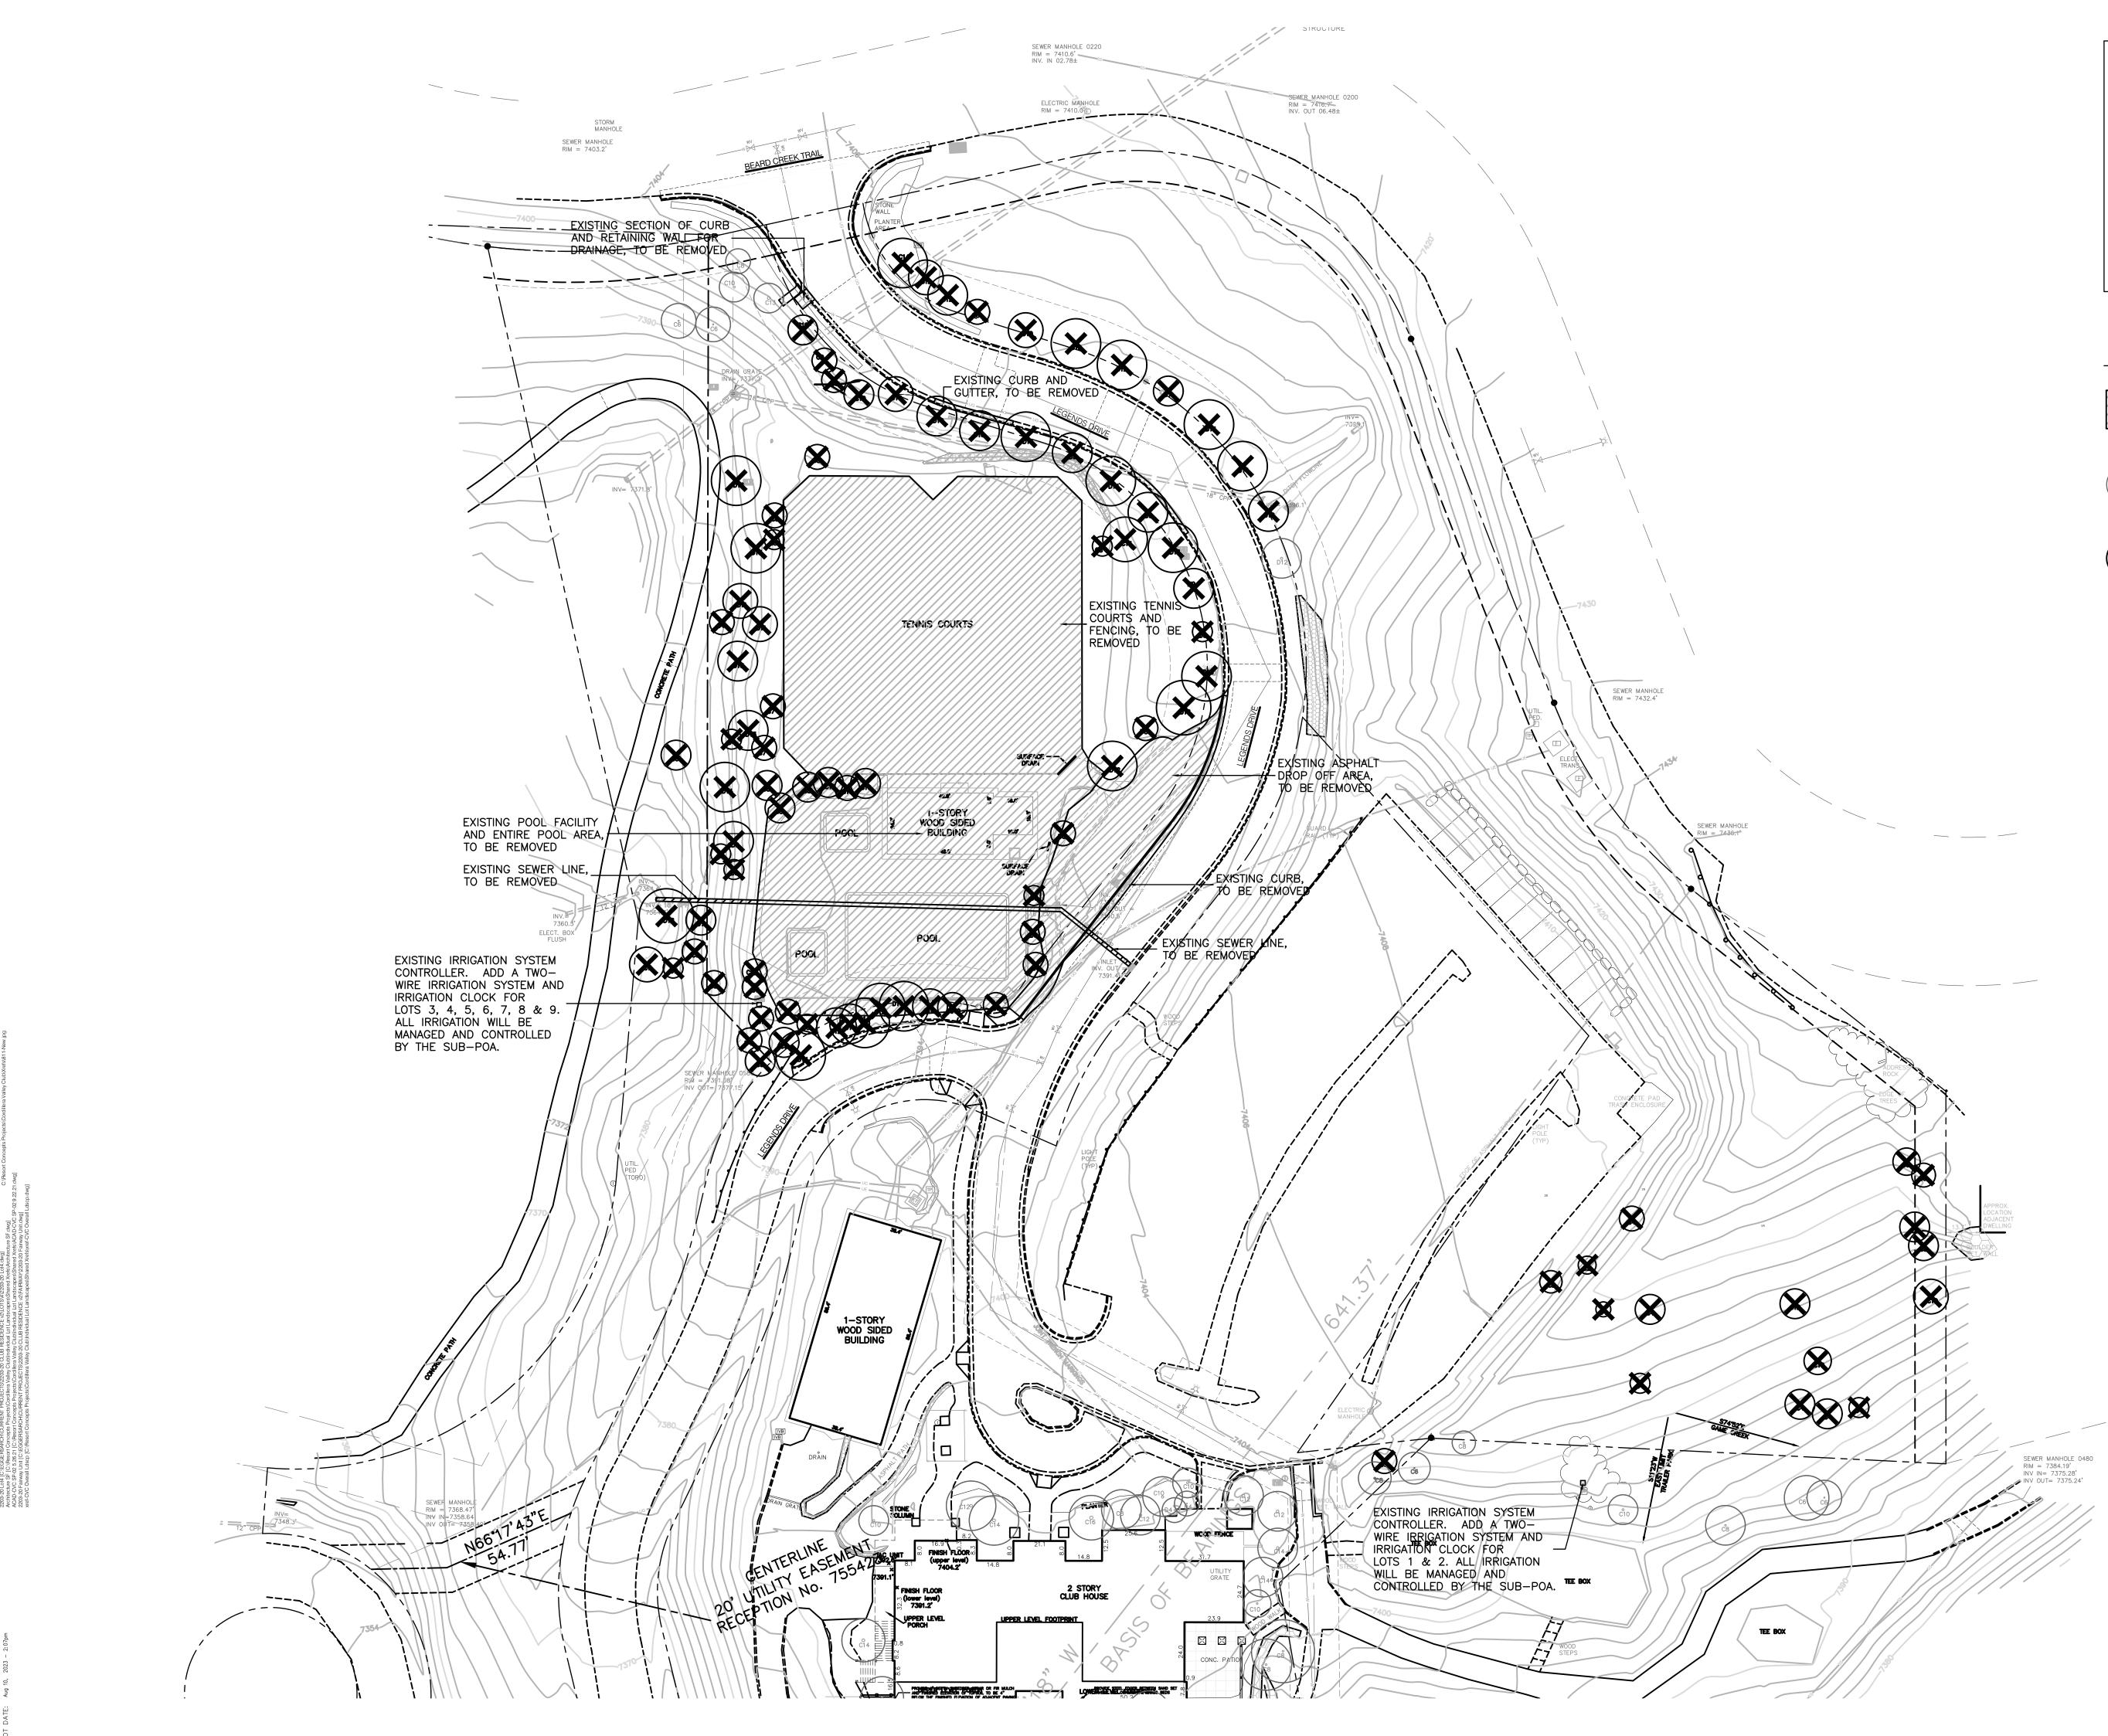

KEYMAP

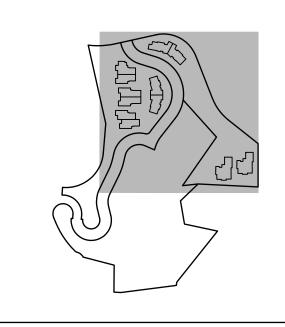

LEGEND

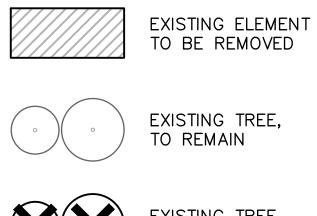

EXISTING TREE, TO REMAIN




EXISTING TREE, TO BE REMOVED



P. 303.572.7876 TTownsend@ResortConceptsCO.com

CORDILLERA VALLEY CLUB	LOT 7	EAGLE COUNTY, COLORADO	
DESIGNED: TT DRAWN: TT CHECKED: JT DATE: July 12, 2021 REVISIONS: PERMIT SET: 8.16.21 ADDED IRRIGATION NOTES: 10.18.21 REVISIONS BASED ON OWNER COMMENTS: 7.5.23			
DERNIT SET SHEET TITLE: EXISTING CONDITIONS & DEMO PLAN SCALE: 1"=30'-0" SHEET NUMBER:			

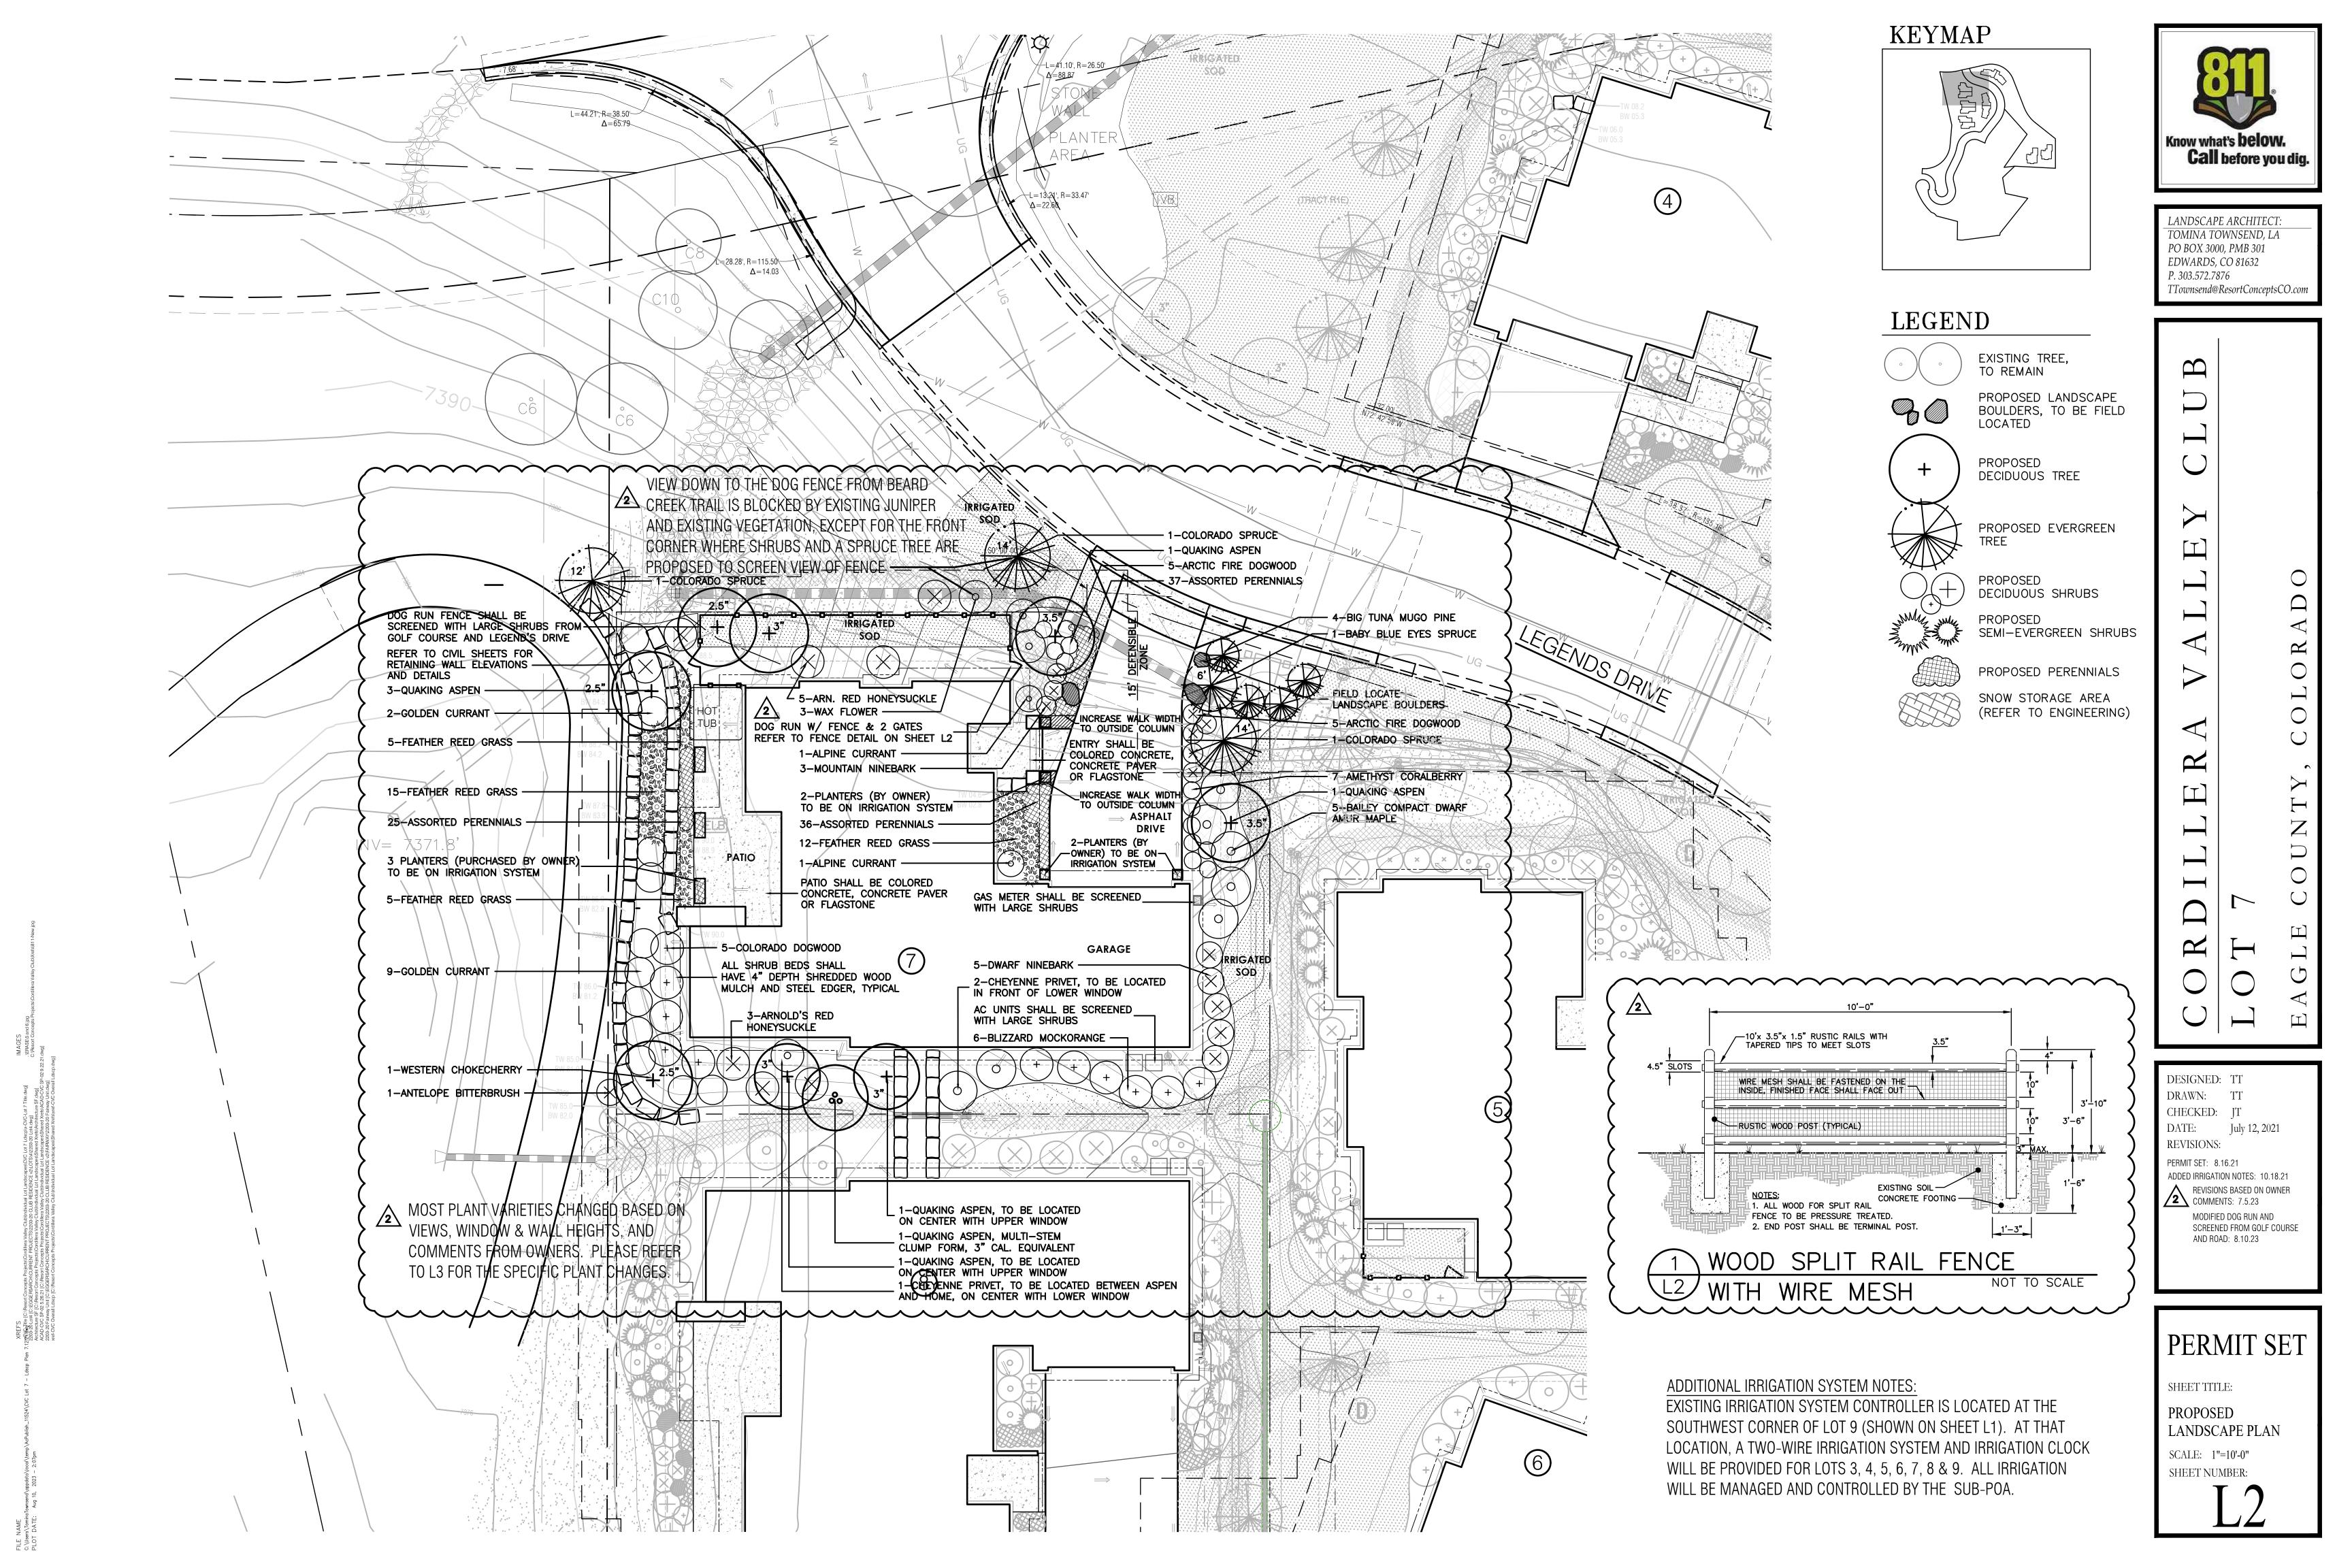

General Notes and Specifications:

1. All areas disturbed by construction and not designated a shrub bed or wildflower seed, shall be planted with the specified native grass seed.

2. The contractor shall maintain positive drainage away from all walls and walkways. Fine grading shall be approved prior to planting.

4. The Landscape Plan shall be reviewed on site prior to installation to ensure planting meets the intent of the design guidelines and county wildfire mitigation standards.

5. All proposed juniper to be limbed to 10'-0" above grade per Eagle County Wildfire

Regulations.

6. Quantity and location of "natural" shrub plantings within Wildfire Mitigation Zone 2 shall be subject to field review by Eagle County Wildfire Mitigation Officer.

7. See Civil Engineering sheets for final grading and drainage.

8. Snow Storage area shall be a min. of 25% of all driveway and parking areas.

Revegetation Notes:

1. Seed shall be broadcast and raked to $\frac{1}{4}$ " depth.

2. Apply Biodegradable Green Dyed-Wood Celluose-Fiber Mulch to all seeded Areas at a rate of 20 lbs. per 1,000 s.f.

3. Prior to seeding, apply min. 6" topsoil, 10 lbs./1,000 s.f. Superphosphate and 40 lbs./1,000 s.f. Biosol Complete Fertilizer.

Fire Mitigation Notes:

1. Zone 1 (15' from building and integral planting): no flammable plants shall be planted within 15' of the sturcture or attachments.

2. Zone 2 (70' from building and Integral planting): a 10' crown seperation must be maintained for all conifers and shrubs orver 4'. A 4' crown seperation must be maintained for shrubs under 4'. 3. Plants listed on forest service publication 6.305 FireWise Plant Material can be used in any zone.

4. Existing junipers within Zone 1 and Zone 2 must be limbed $\frac{1}{3}$ of their total height, but no more than 10'.


5. Dead limbs shall be removed from all existing Serviceberrys within Zone 1 or Zone 2. 6. Final existing vegetation to be limbed or removed will be subject to the constraints of the final unit site plans and reviewed on site with a representative from the Eagle County Wildfire Mitigation, Cordillera DRB and Resort Concepts on a unit by unit basis

prior to construction. SHRUBS IN WOOD CHIP OR COBBLE MULCH, DIMENSION PERENNIALS, NATIVE SEED, OR WILDFLOWER SOD VARIES (REFER TO LANDSCAPE PLAN) (RE: PLAN) • 4". MIN. OVERHANG SPECIFIED MULCH MIX BELOW BUILDING DRIP LINE, 4" TO 6' DEPTH. SET FLUSH CORCEPT WITH FINISH GRADE. PROVIDE SAMPLE. SPECIFIED FILTER FABRIC (WEED BARRIER) ARMORED DRIP LINE MULCH L2 NOT TO SCALE SHRUB BED W/ SPECIFIED MULCH DEPTH -LAWN AS SPECIFIED 2080Q SPECIFIED STEEL EDGING SPECIFIED LANDSCAPE FABRIC ROLL EDGE UNDER EDGING AS SHOWN METAL STAKES AS SPECIFIED NOTES: 1) SET ALL EDGING 1" ABOVE FINISH GRADE AS SHOWN. 2) EDGING SHALL ABUT ALL CONCRETE CURBS AND WALKS PERPENDICULAR, AND FLUSH W/ GRADES OF CONCRETE.


3) ALL JOINTS TO BE SECURELY STAKED.


4) CONTRACTOR SHALL CUT TOP EDGE(S) AS NEEDED TO BE PARALLEL WITH GRADE.



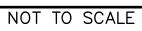

Legend &	Irrigation Ca
Permanen	t Irrigation
	Permanent P Irrigation For
	Permanent m or drip irriga perennial bec
+	Permanent D For B&B Tree
	Permanent D For 5 gal. St

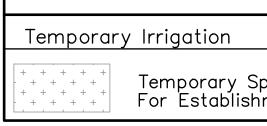

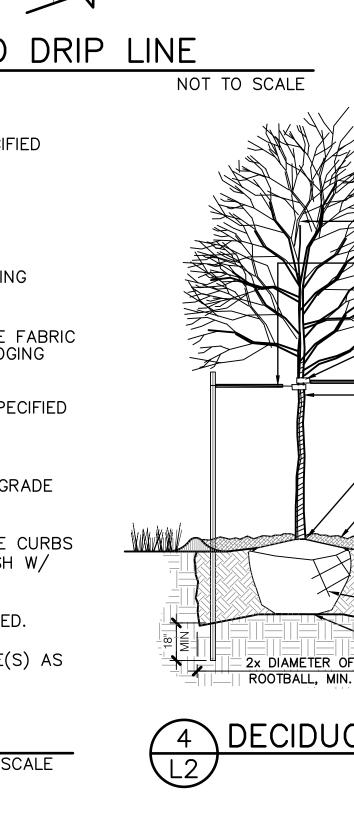

		~~~~~~~~~~~~~~~~~~~~~~~~~~~~~~~~~~~~~~~
alculations	Square Footage of Irrigation	Water Usage (assuming a spray rate of 12 gal for a 450 sf zone for 15 min.=.25 inches)
Pop—Up Spray or Bluegrass Sod	452 SF	12 gallons per 15 min. run time twice per week = 24 gal/week
micro—spray ation for eds	2 -104 73 SF	(assuming a peren. drip rate 2gal/week) 73 perennials x 2 gal = 146 gal/week
Drip Irrigation	<del>-9-</del> 13 TREES x 4.5 SF = 58.5 SF	(assuming a tree rate of 6 gal/hour) 13 trees x 6 gal = 78 gal/hour three times per week = 234 gal/week
Drip Irrigation 🖄	<del>-88-</del> 106 SHRUBS x 3 SF = 318 SF	(assuming a shrub rate of 2 gal/hour) 106 shrubs x 2 gal = 212 gal/hour three times per week = 636 gal/week
{	TOTAL PERMANENT IRRIGATION WATER AREA: 901.5 SF	TOTAL PERMANENT IRRIGATION WATER USE: 1,040 gallons per week
	$\cdots \cdots $	
Spray Irrigation hment of Native Seed	75 SF	2 gal. per 15 min. run time (Temporary to establish seed)

NOTE:

1. See Civil Engineering sheets for final grading and drainage.

IRRIGATION NOTES:

1. Design Criteria: Design automatic underground irrigation system to uniformly irrigate all planting areas. Zone irrigated turf grass and shrub planting areas separately. Provide drip irrigation for shrub beds. Provide micro-spray heads or drip irrigation, depending on plant material, in perennial and groundcover beds. Design rotors for turf grass areas more than 40' wide, pop-up spray heads for areas less than 40' wide. 2. All trees and shrubs to be drip irrigated.

### NATIVE SEED REVEGETATION MIX

(ROADWAY MIX):		
Scientific Name	Variety	Percent
Bluebunch Wheatgrass Agropyron spicatum	Secar	9.77
Slender Wheatgrass Agropyron trachycaulum	Revenue	28.28
Western Wheatgrass Agropyron smithii	Arriba	47.58
Sheep Fescue Festuca ovina	MX-86	10.08
Seeding Rate: Hydroseed Hand Broa	@ 20 Lbs/Ac dcast @ 40 L	re bs/Acre

NATIVE SEED REVEGETATION MIX (NON-ROADWAY MIX):			
Scientific Name	Variety	Percent	
Bluebunch Wheatgrass Agropyron spicatum	Secar	26.26	
Slender Wheatgrass Agropyron trachycaulum	Revenue	26.14	
Western Wheatgrass Agrop <i>y</i> ron smithii	Arriba	14.03	
Sheep Fescue Festuca ovina	MX-86	9.94	
Arizona Fescue Festuca arizonica	Redondo	8.09	
Canby Bluegrass Poa canbyi		5.44	
Bottlebrush Squirreltail Elymus elymoides		4.25	
Prairie Junegrass 1.8 Koeleria macrantha			
Seeding Rate: Hydroseed @ 20 Lbs/Acre			

·9 · Hand Broadcast @ 40 Lbs/Acre

SET SHRUB 1" HIGHER THAN THE FINISHED PRUNE ALL DEAD OR -DAMAGED WOOD PRIOR TO PLANTING. BED GRADE. DIG PLANT PIT TWICE AS WIDE & HIGH AS THE CONTAINER COMPACTED BACKFILL MIX FILL PLANT PIT WITH 1/2 SPECIFIED SOIL MIX & 1/2 PIT SOIL - APPLY SPECIFIED MULCH. TAPER MULCH TO 1" AT EDGE OF LOOSEN SIDES OF PLANT PIT & WATER IN WELL TO ELIMINATE LARGE AIR POCKETS. PAVEMENT. CARE SHOULD BE TAKEN NOT TO DAMAGE THE SHRUB OR ROOT-BALL WHEN REMOVING IT FROM ITS CONTAINER. ALL JUNIPER PLANTS SHOULD BE PLANTED SO TOP OF ROOT MASS NOTE: BROKEN OR OCCURS AT FINISH CRUMBLING ROOT-GRADE OF MULCH BALLS WILL BE REJECTED. _AYER. SHRUB PLANTING

NOT TO SCALE

L2

PRUNE DAMAGED OR DEAD WOOD

- DO NOT CUT LEADER

12 GAUGE GALV. WIRE WITH


3/4" DIA. WHITE PVC ON ENTIRE LENGTH OF EACH WIRE - SPECIFIED TREE STRAP

- SPECIFIED POSTS-ALIGN NW/SE, 2 PER TREE SET MIN 18" INTO UNDISTURBED SUBGRADE

- WRAP ENTIRE SURFACE OF TRUNK UP TO SECOND BRANCH WITH SPECIFIED WRAPPING SECURED © TOP AND BOTTOM & AT TWO FOOT INTERVALS. PLANT TREE W/ TOP OF ROOTBALL 2"-4" ABOVE FINAL GRADE MULCH RING, MIN. 48" IN DIA., 4" IN DEPTH. 4" HEIGHT WATER SAUCER IN NON-TURF AREAS

> -SPECIFIED BACKFILL MIXTURE AS PER SPECIFICATIONS AFTER TREE IS SET IN PLANTING PIT, REMOVE ALL TWINE & WIRE FROM TOP & SIDES OF ROOTBALL PULL BURLAP BACK 1/3 (MIN.) - SET ROOTBALL ON UNDISTURBED SUBGRADE-DO NOT OVER-




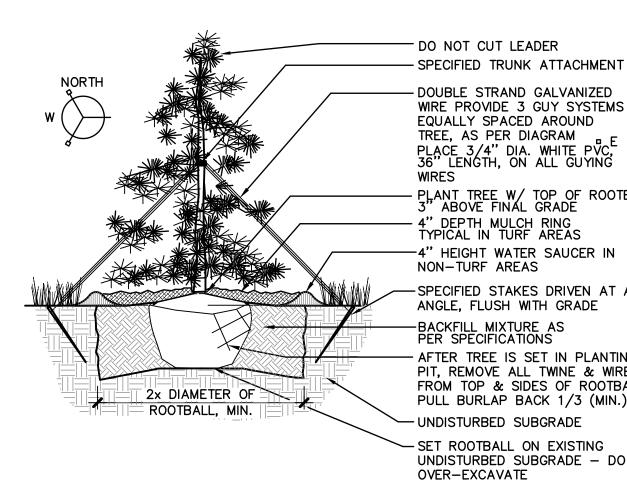

5

L2

1. INSTALL SPECIFIED MULCH TO DRIPLINE OF TREE WHERE PLANTED IN LAWN AREAS. 2. DO NOT PROVIDE WATER BASIN IN IRRIGATED LAWN AREAS.

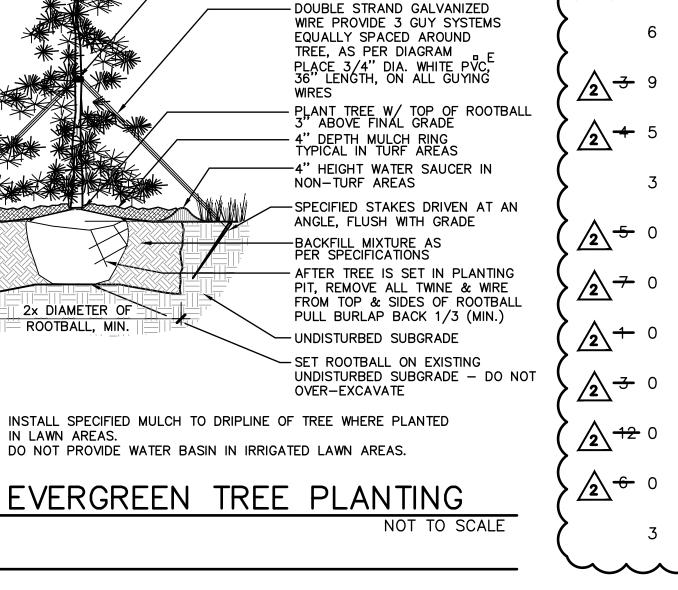

# PROPOSED PLANT MATERIALS LIST NOTE: ALL PLANT MATERIAL FOUND WITHIN 15' DEFENSIBLE ZONE IS CHOSEN

· <u>/2</u> + 2

1 2 + 2

/2 + 0

		PLANT MATERIAL FOUND W SSU EXTENSION FIREWISE F			HUSEN	$\mathbf{O}$
QUAN	•	COMMON/ BOTANICAL NAME EVERGREEN TREES (ONLY			COMMENTS	
	$\frown$	Baby Blue Eyes Spruce (a	compact variety	$\overline{}$	Specimen quality	
1		Picea pungens 'Baby Blue Colorado Blue Spruce	Eyes´ 2	12' ht.	B&B, staked Specimen quality	Know what's <b>below.</b> <b>Call before you dig.</b>
<b>2</b> + 2	2	Picea pungens Colorado Blue Spruce	2	14' ht.	B&B, staked Specimen quality	<u>}</u>
		Picea pungens DECIDUOUS TREES			B&B, staked	LANDSCAPE ARCHITECT: TOMINA TOWNSEND, LA
	2	Quaking Aspen Populus tremuloides	1 & 2	2.5" cal.	Specimen quality B&B, guyed	PO BOX 3000, PMB 301 EDWARDS, CO 81632 P. 303.572.7876
<b>2</b> + 3	5	Quaking Aspen Populus tremuloides	1 & 2	3" cal.	Specimen quality B&B, guyed	TTownsend@ResortConceptsCO.com
	2	Quaking Aspen Populus tremuloides	1 & 2	3.5" cal.	Specimen quality B&B, guyed	
<b>2</b> + 1		Quaking Aspen Populus tremuloides	1 & 2	multi-stem clump form	Specimen quality B&B, guyed	$\langle \mathbf{m}  $
	)	Amur Maple Acer ginnala	1 & 2	2.5" cal.	Specimen quality B&B, guyed	
<u>2</u> 2 1		Western Chokecherry Prunus virginiana melanoco	1 & 2 arpa	2.5" cal.	Specimen quality B&B, guyed	$\langle \square \rangle$
	)	Native Mountain Ash Sorbus scopulina	1 & 2	2.5" cal.	Specimen quality B&B, guyed	$\langle \cup  $
		PERENNIALS & ORNAMENT	AL GRASSES (A	pproximately 73	sf. @ 12" O.C. spacing)	$\langle \rangle$
<b>2</b> ¹⁰⁴ 7	'3	Assorted Perennials (All perennials to be chos	en by landscape	installer from Fl	REWISE PLANT MATERIALS LIST)	
<b>2</b> + 3	57	Feather Reed Grass Calamagrostis x acutiflora	1 & 2 'Karl Foerster'	1 gal.	Container Full	
		EVERGREEN/SEMI-EVERGRE	EN/BROADLEAF	EVERGREEN SHRI	JBS	AD AD
	)	Common Mountain Mahogo Cercocarpus montanus	·	5 gal.	Container, 5 canes minimum 24"—36" ht.	$\langle R_A \rangle$
	)	Littleleaf Mountain Mahoga Cercocarpus intricatus	ny 1 & 2	5 gal.	Container, 5 canes minimum 18"—24" ht.	$\begin{bmatrix} \Gamma \\ \Gamma $
<u>^</u> 5 0	)	Purple Creeping Colorado I Mahonia repens Darkstar	Holly 1 & 2	5 gal.	Container, Specimen Quality 10"—18" min. spread	
	)	Rock Cotoneaster Cotoneaster horizontalis	1 & 2	5 gal.	Container, 5 canes minimum 12"—18" ht.	
<b>2</b> + 4	ŀ	Big Tuna Mugo Pine Pinus mugo 'Big Tuna'	1 & 2	5 gal.	Container, Specimen Quality 18"—24" ht.	
		DECIDUOUS SHRUBS				X I Z Z
2 5 7	7	Amethyst Coralberry Symphoricarpos x doorenb	1 & 2 osii Amethyst	5 gal.	Container, 5 canes minimum 12"—18" ht.	
	2	Alpine Currant Ribes alpinum	1 & 2	5 gal.	Container, 5 canes minimum 18"—24" ht.	
<b>2</b> <del>3</del> 1		Antelope Bitterbrush Purshia tridentata	1 & 2	5 gal.	Container, 5 canes minimum 12"—18" ht.	
<b>2</b> + 1	0	Arctic Fire Dogwood Cornus sericea ARCTIC FIR	1 & 2 E	5 gal.	Container, 5 canes minimum 12"—18" ht.	
<u>∕</u> 2 <del>7</del> 8	3	Arnold's Red Honeysuckle Lonicera tatarica 'Arnold's		5 gal.	Container, 5 canes minimum 24"—36" ht.	
<b>2</b> + 5	5	Bailey Compact Dwarf Am Acer ginnala 'Bailey Comp		5 gal.	Container, 5 canes minimum 24"—36" ht.	$\sum_{i=1}^{n}  U_{i}  \leq 1$
<u>2</u> 5 0	)	Burkwood Daphne Daphne burkwoodii 'Somers	1 & 2 set'	5 gal.	Container, 5 canes minimum 18"—24" ht.	
	)	Bog Brush Betula glanulosa	1 & 2	5 gal.	Container, 5 canes minimum 24"—36" ht.	DESIGNED: TT DRAWN: TT
<b>2</b> + 3	5	Cheyenne Privet Ligustrum vulgare 'Cheyenı	1 & 2 ne'	5 gal.	Container, 5 canes minimum 24"—36" ht.	CHECKED: JT DATE: July 12, 2021
<b>2</b> • 3	5	Colorado Dogwood Cornus sericea coloradense	1 & 2 e	5 gal.	Container, 5 canes minimum 24"—36" ht.	REVISIONS: PERMIT SET: 8.16.21 REVISED IRRIGATION NOTES: 10.18.21
6	5	Blizzard Mockorange Philadelphus lewisii 'Blizzar	1 & 2 ď	5 gal.	Container, 5 canes minimum 24"—36"ht.	REVISIONS BASED ON OWNER COMMENTS: 7.5.23
<u>∕</u> 2 → 9	)	Golden Currant Ribes aureum	1 & 2	5 gal.	Container, 5 canes minimum 24"—36" ht.	ζ
<b>2-+</b> 5	5	Dwarf Ninebark Physocarpus opulifolius 'Do	1 & 2 art's Gold'	5 gal.	Container, 5 canes minimum 18"—24" ht.	5
. 3	5	Mountain Ninebark Physocarpus monogynus	1 & 2	5 gal.	Container, 5 canes minimum 12"—18"ht.	
	)	Heath Erica carnea 'Springwood I	1 & 2 Pink'	5 gal.	Container, 5 canes minimum 12"—18"ht.	<b>VERMIT SET</b>
	)	Pawnee Buttes Sandcherry Prunus pumila besseyi Pav		5 gal.	Container, 5 canes minimum 24"—36"ht.	$\langle  $
	)	Rocky Mountain Maple Acer glabrum	1 & 2	5 gal.	Container, 5 canes minimum 36"—48" ht.	SHEET TITLE: LANDSCAPE
	)	Rock Spirea Holodiscus dumosus	1 & 2	5 gal.	Container, 5 canes minimum 18"—24" ht.	NOTES & DETAILS
<u>2</u> ⁻¹² 0	)	Mountain Snowberry Symphoricarpos oreophilus	1 & 2	5 gal.	Container, 5 canes minimum 10"—12" ht.	SCALE: NOT TO SCALE SHEET NUMBER:
	)	Boulder Raspberry Rubus deliciosus	1 & 2	5 gal.	Container, 5 canes minimum 18"—24" ht.	
3	5	Wax Flower Jamesia americana	1 & 2	5 gal.	Container, 5 canes minimum 24"—36" ht.	

Subject: Re: POA Approval – Lot 7 Modifications

Date: Friday, July 21, 2023 at 12:30:52 PM Mountain Daylight Time

From: Kim Gill

To: Taylor Hermes, Heidi Troester, David Kochel

CC: Crystal Watson, Derrick Gerhardt, Jeff Townsend

Attachments: image001.png

Ok by me

From: Taylor Hermes <thermes@resortconceptsco.com>
Date: Friday, July 21, 2023 at 12:28 PM
To: Heidi Troester <heidift@comcast.net>, Kim Gill <kgill@sableholdings.com>, David Kochel
<daviddkochel@gmail.com>
Cc: Crystal Watson <cwatson@resortconceptsco.com>, Derrick Gerhardt
<dgerhardt@resortconceptsco.com>, Jeff Townsend <jtownsend@resortconceptsco.com>
Subject: POA Approval – Lot 7 Modifications

Hello all,

Please find the attached plans sufficient for the Club Residence's POA review of modifications to Lot 7. The homeowner would like to modify their exterior lighting to the attached dark-sky compliant fixture, as well as landscape modifications, including the addition of trees and a dog run.

With your approval, I can proceed with submitting to the DRB for their approval as well. If you have any questions or concerns, please don't hesitate to reach out.

Thank you,



Taylor Hermes

c: (512) 468-3012 o: (970) 926-1720 <u>ResortConceptsCO.com</u> Subject: Re: POA Approval - Lot 7 Modifications

Date: Monday, July 24, 2023 at 10:43:18 AM Mountain Daylight Time

From: David Kochel

To: Taylor Hermes

CC: Heidi Troester, Kim Gill, Crystal Watson, Derrick Gerhardt, Jeff Townsend

Approved on my end.

On Jul 21, 2023, at 11:28 AM, Taylor Hermes <thermes@resortconceptsco.com> wrote:

Hello all,

Please find the attached plans sufficient for the Club Residence's POA review of modifications to Lot 7. The homeowner would like to modify their exterior lighting to the attached dark-sky compliant fixture, as well as landscape modifications, including the addition of trees and a dog run.

With your approval, I can proceed with submitting to the DRB for their approval as well. If you have any questions or concerns, please don't hesitate to reach out.

Thank you,

#### Taylor Hermes

c: (512) 468-3012 o: (970) 926-1720 <u>ResortConceptsCO.com</u>

<CVC Lot 7 - Ldscp Plan 7.19.23.pdf><ODB0027-18-L2.pdf>